


1:1000 PHASING LAYOUT FOR SITE DEVELOPMENT

0 10 20 30 40 50 m
SCALE 1:1000




1:1000 DETAIL 1: INFRASTRUCTURE WITHIN A DEVELOPMENT PHASE BOUNDARY

0 10 20 30 40 50 m
SCALE 1:1000

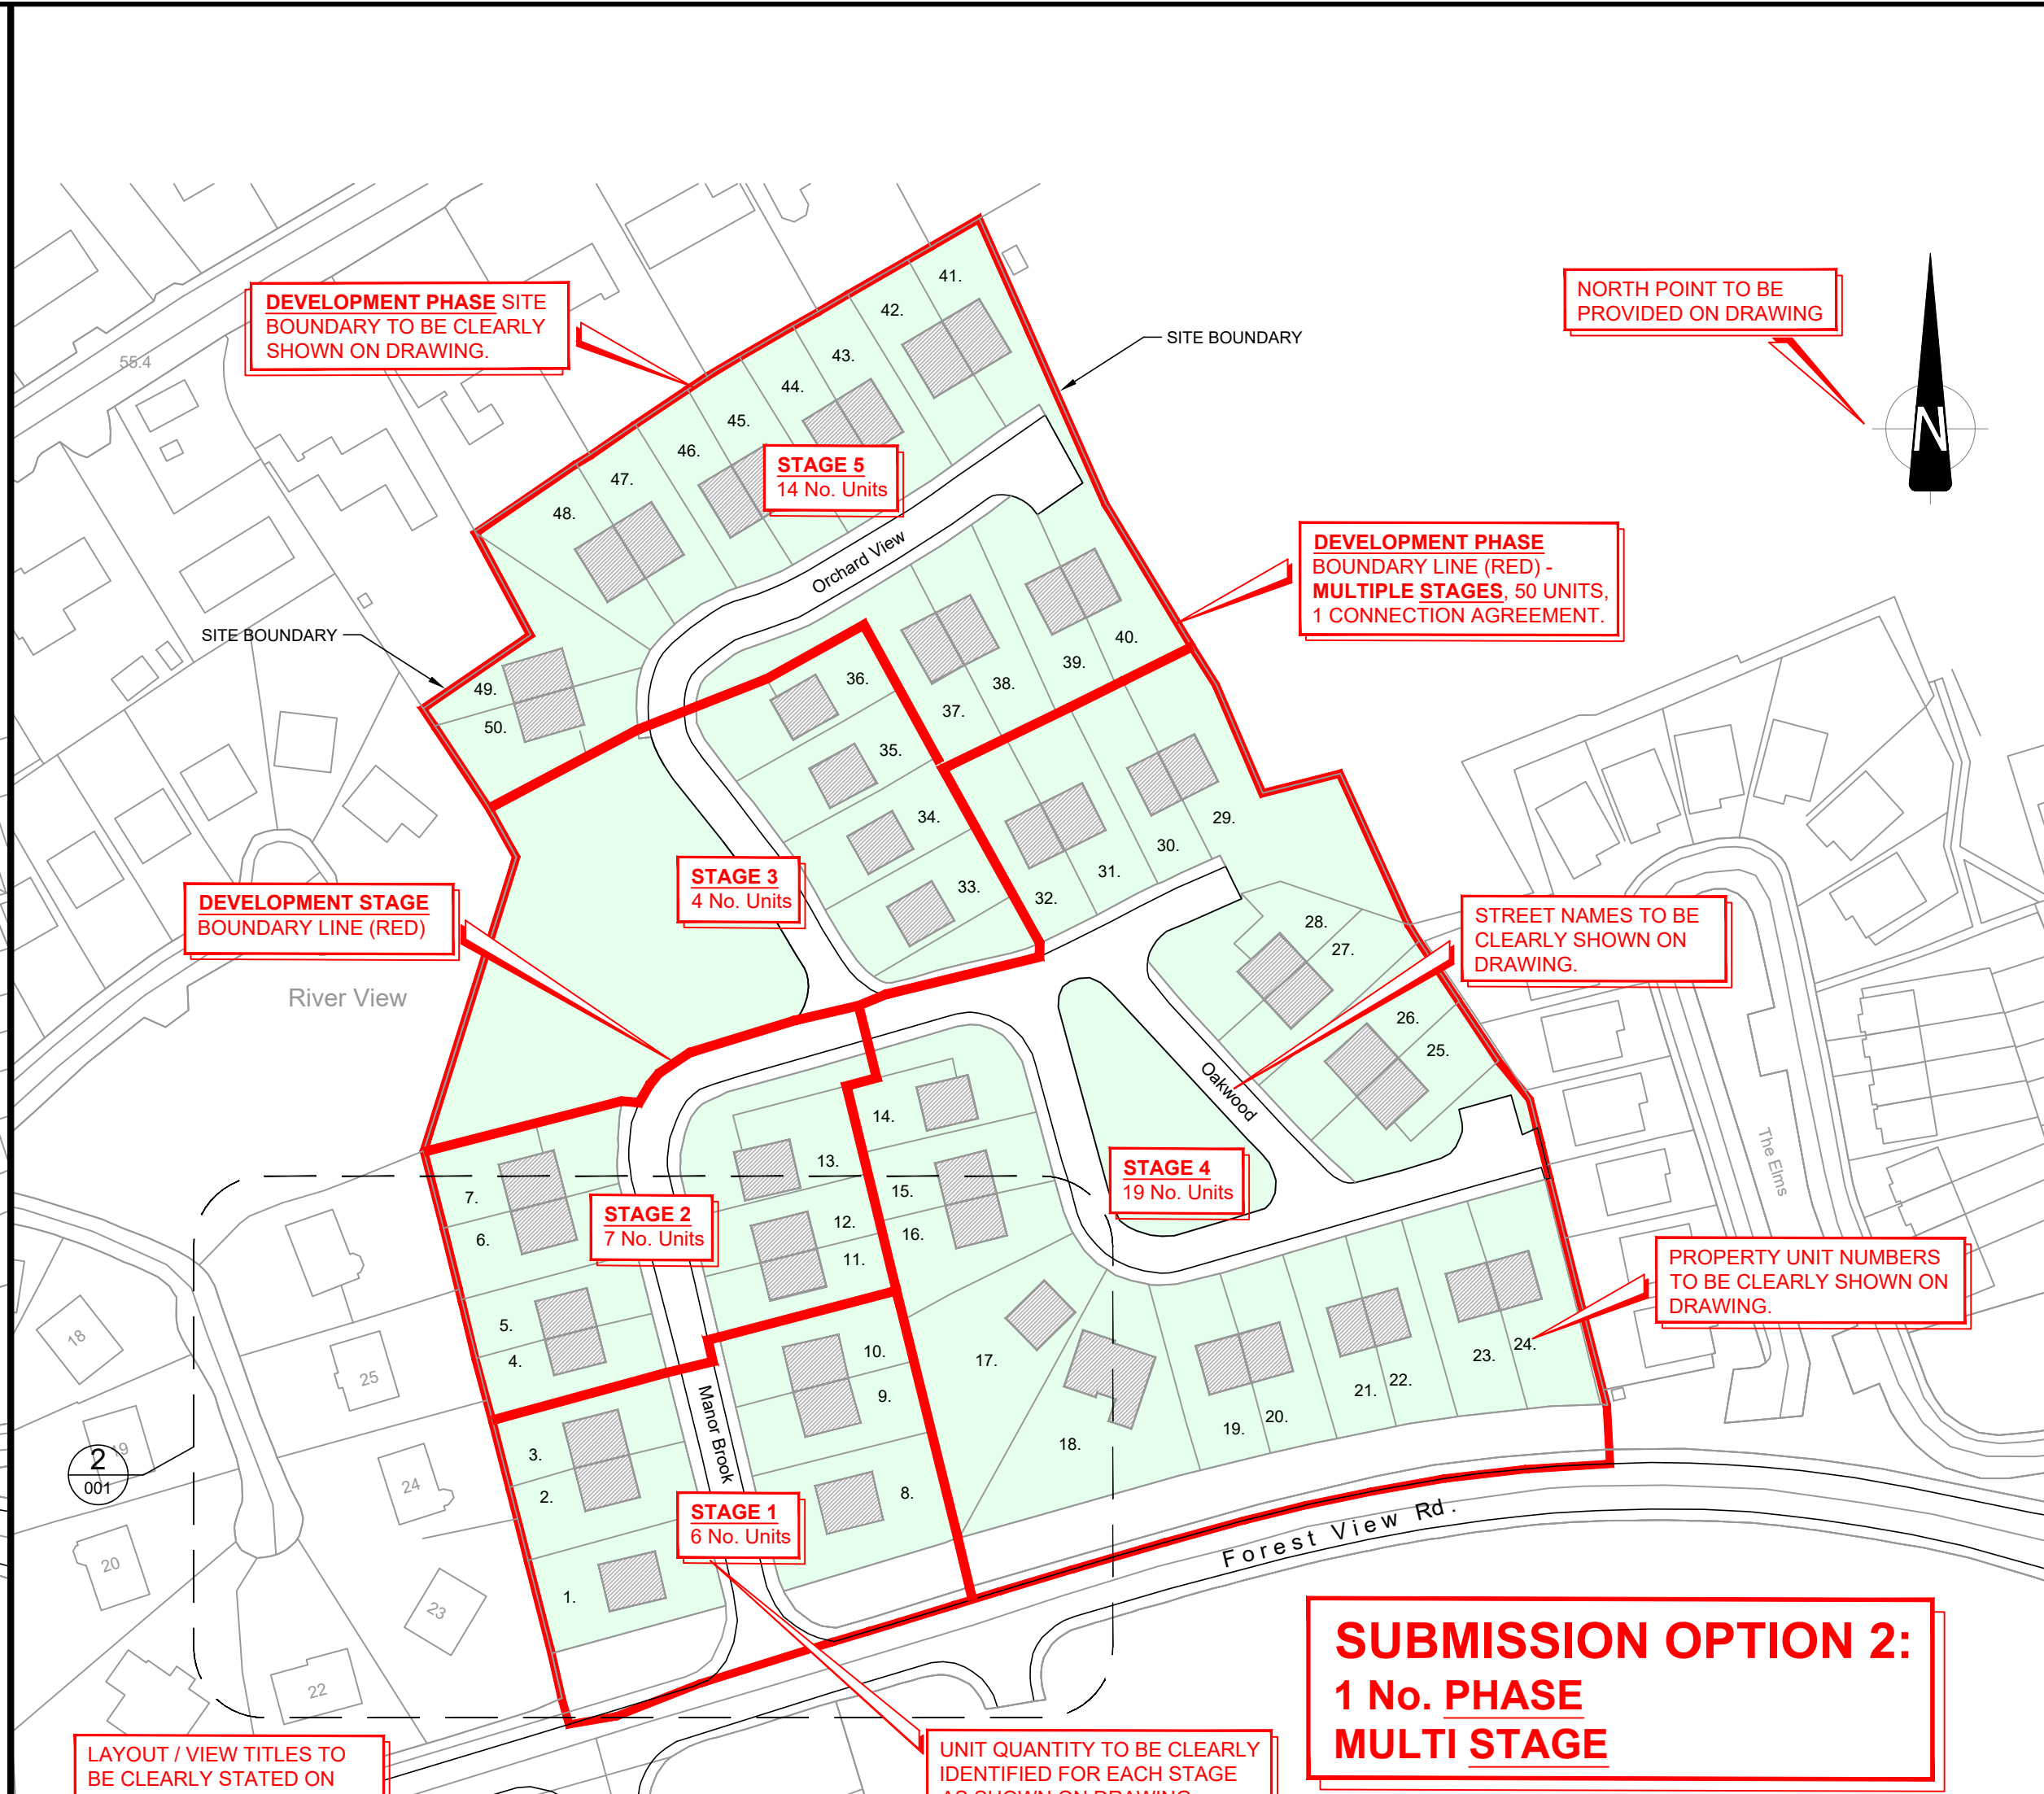

1:1000 PHASING AND STAGING LAYOUT FOR SITE DEVELOPMENT

0 10 20 30 40 50 m
SCALE 1:1000

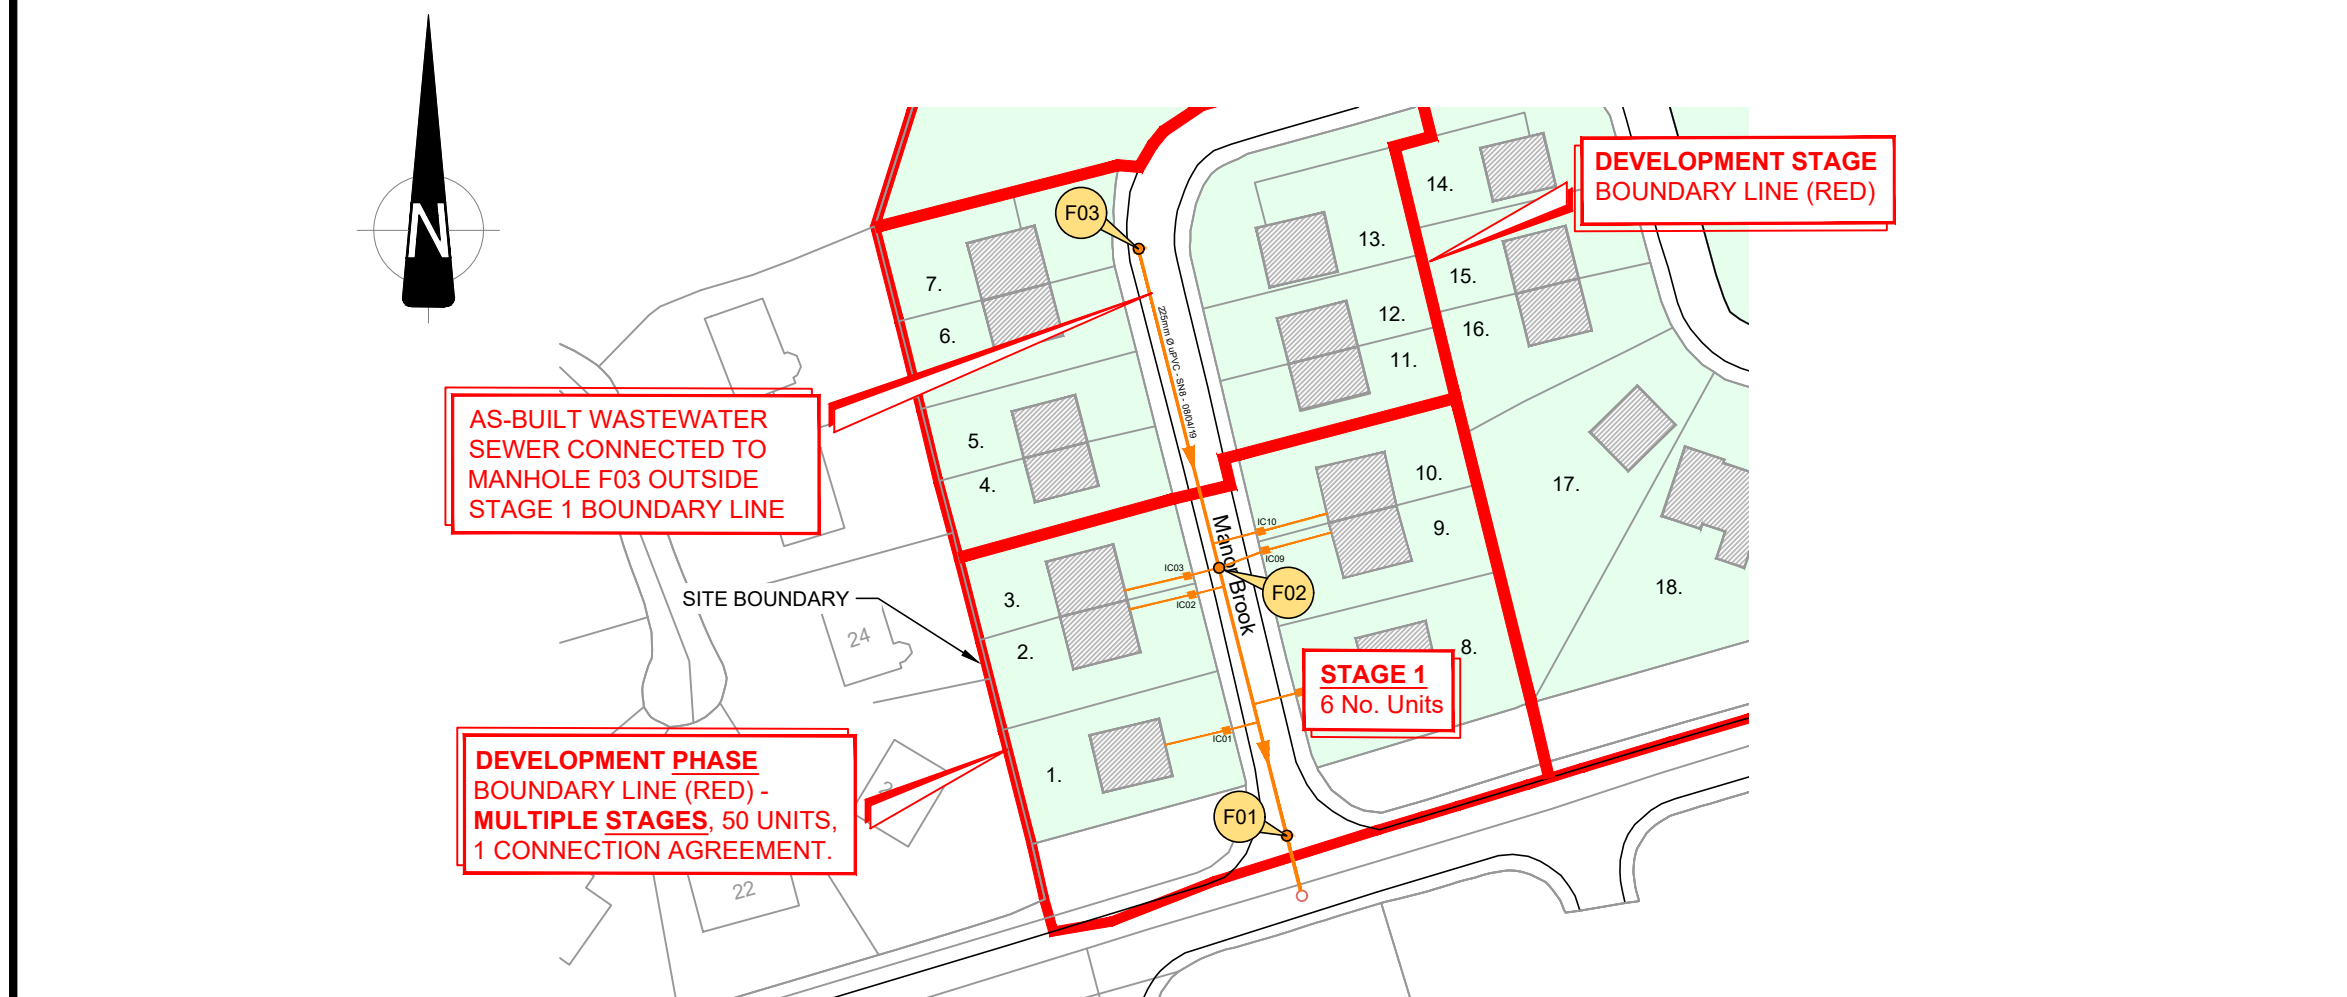

1:1000 DETAIL 2: STAGE 1 SUBMISSION WITHIN A DEVELOPMENT MULTI PHASE BOUNDARY

0 10 20 30 40 50 m
SCALE 1:1000

LEGEND:

DEVELOPMENT PHASE BOUNDARY
DEVELOPMENT STAGE BOUNDARY

LEGEND TO BE PROVIDED
ON DRAWING

NOTES:

1. XXXX

SAMPLE
DRAWING

CDS TRACKER NUMBER TO
BE CLEARLY STATED ON
DRAWING.

CDS-1900xxxxxx

DRAWING TO BE REVISED
TO "AS-BUILT" STATUS

REV.	DATE	DESCRIPTION	BY	CHKD	APPR
AB1	MAR 2025	AS-BUILT RECORD DRAWING	PD	-	-

Uisce Éireann
Irish Water

Development

DEVELOPMENT TITLE TO BE
CLEARLY STATED.

Developer / Consultant

NAME AND ADDRESS OF
DEVELOPER AND/OR CONSULTANT
TO BE CLEARLY SHOWN.

Title

AS-BUILT: PHASING AND STAGING
LAYOUTS FOR SITE DEVELOPMENT

DRAWING TITLE TO BE
CLEARLY STATED.

Drawn	PD	Scale	SHOWN	Drawing Number	Rev.
Chkd	RH	Date	MAR 2025	001-IW-SA-PH	AB1
Appd.	M McG	Status	AS-BUILT		