


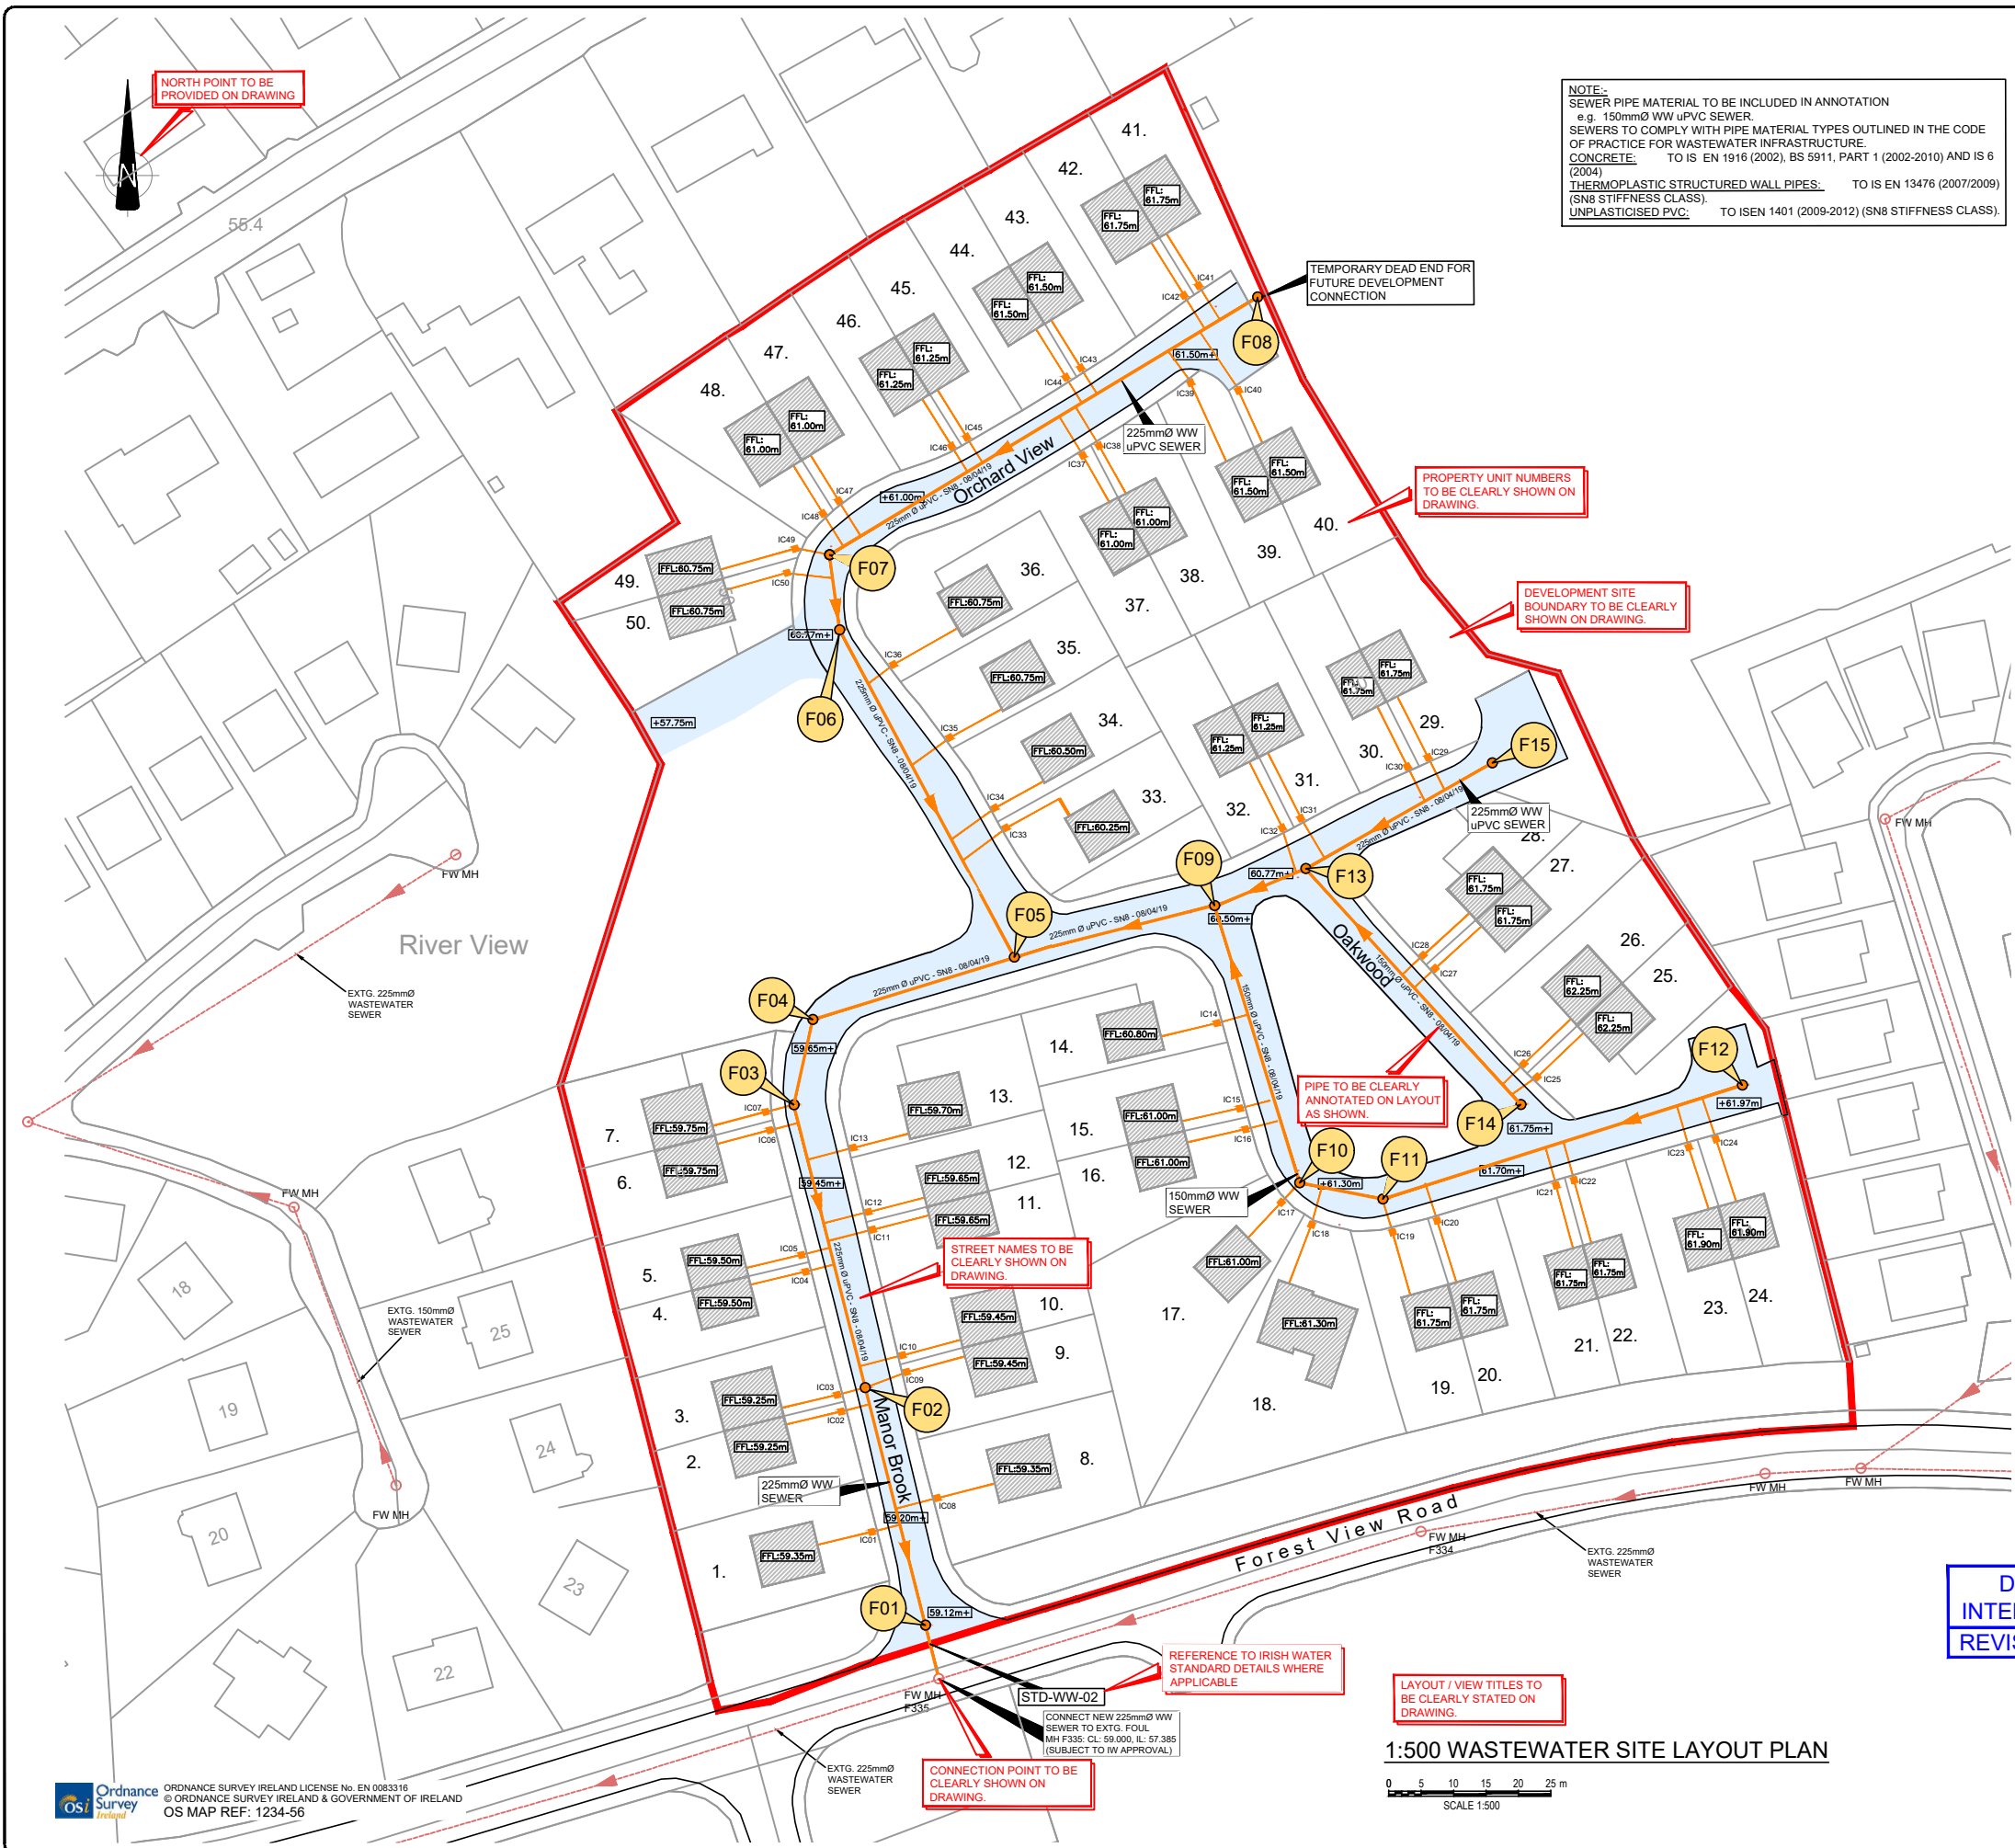

NOTE:
SEWER PIPE MATERIAL TO BE INCLUDED IN ANNOTATION
e.g. 150mm Ø WW uPVC SEWER
SEWERS TO COMPLY WITH PIPE MATERIAL TYPES OUTLINED IN THE CODE OF PRACTICE FOR WASTEWATER INFRASTRUCTURE.
CONCRETE: TO IS 1916 (2002), BS 5911, PART 1 (2002-2010) AND IS 6 (2004)
THERMOPLASTIC STRUCTURED WALL PIPES: TO IS 13476 (2007/2009) (SN8 STIFFNESS CLASS).
UNPLASTICISED PVC: TO IS 1401 (2009-2012) (SN8 STIFFNESS CLASS).

Wastewater Schedule:-		
Type	Location Co-Ords (ING)	
MH F01	X = xxxxxx	Y = xxxxxx
MH F02	X = xxxxxx	Y = xxxxxx
MH F03	X = xxxxxx	Y = xxxxxx
MH F04	X = xxxxxx	Y = xxxxxx
MH F05	X = xxxxxx	Y = xxxxxx
MH F06	X = xxxxxx	Y = xxxxxx
MH F07	X = xxxxxx	Y = xxxxxx
MH F08	X = xxxxxx	Y = xxxxxx
MH F09	X = xxxxxx	Y = xxxxxx
MH F10	X = xxxxxx	Y = xxxxxx
MH F11	X = xxxxxx	Y = xxxxxx
MH F12	X = xxxxxx	Y = xxxxxx
MH F13	X = xxxxxx	Y = xxxxxx
MH F14	X = xxxxxx	Y = xxxxxx
MH F15	X = xxxxxx	Y = xxxxxx
IC01	X = xxxxxx	Y = xxxxxx
IC02	X = xxxxxx	Y = xxxxxx
IC03	X = xxxxxx	Y = xxxxxx
IC50	X = xxxxxx	Y = xxxxxx

LEGEND:

- F01 PROPOSED WASTEWATER MANHOLE
- PROPOSED INSPECTION CHAMBER & WASTEWATER SERVICE CONNECTION
- PROPOSED WASTEWATER SEWER
- PROPOSED WASTEWATER RISING MAIN
- PROPOSED WASTEWATER PUMPING STATION
- EXISTING WASTEWATER SEWER & MANHOLE
- EXISTING WASTEWATER RISING MAIN
- EXISTING WASTEWATER PUMPING STATION
- REFER TO STD-WW-04 FOR DETAILS
- SITE BOUNDARY

SYMBOLS LEGEND TO BE PROVIDED ON DRAWING

NOTES:

1. ALL PIPE MATERIALS SHALL BE SPECIFIED ON THE RELEVANT DRAWINGS, & SHALL COMPLY WITH THE REQUIREMENTS OF SECTION 3.13 OF THE CODE OF PRACTICE FOR WASTEWATER INFRASTRUCTURE.

Manhole Level Schedule:		
MH No.	C.L.	I.L.
F01	59.122	57.385
F02	59.272	57.769
F03	59.622	58.072
F04	59.672	58.162
F05	59.872	58.421

MANHOLE COVER LEVELS AND INVERT LEVELS TO BE PROVIDED ON DRAWING

F10	61.520	59.023
F11	61.620	59.280
F12	61.970	60.587
F13	60.780	59.274
F14	61.750	60.230
F15	61.300	59.767

Note:-
ANNOTATED LONGITUDINAL SECTIONS FOR WASTEWATER INFRASTRUCTURE ARE ALSO TO BE PROVIDED.

CDS TRACKER NUMBER TO BE CLEARLY STATED ON DRAWING.

CDS-1900xxxxxx

DRAWING TO BE REVISED TO "AS-BUILT" STATUS	
REV.	DATE
AB1	MAR 2025
AS-BUILT RECORD DRAWING	
REV.	DATE
DESCRIPTION	
BY: CHKD APPR	

Uisce Éireann Irish Water

DEVELOPMENT TITLE TO BE CLEARLY STATED.

NAME AND ADDRESS OF DEVELOPER AND/OR CONSULTANT TO BE CLEARLY SHOWN.

DRAFT COPY FOR INTERNAL REVIEW ONLY

REVISION: D6

WASTEWATER SITE LAYOUT PLAN

DRAWING TITLE TO BE CLEARLY STATED.

Drawn	RH	Scale	AS SHOWN	Drawing Number	Rev.
Check	RH	Date	MAR 2025	002-IS-SA-WW	AB1
Appr'd	M McG	Status	As Built		