


Horizontal Scale = 1:500, Vertical Scale = 1:50.

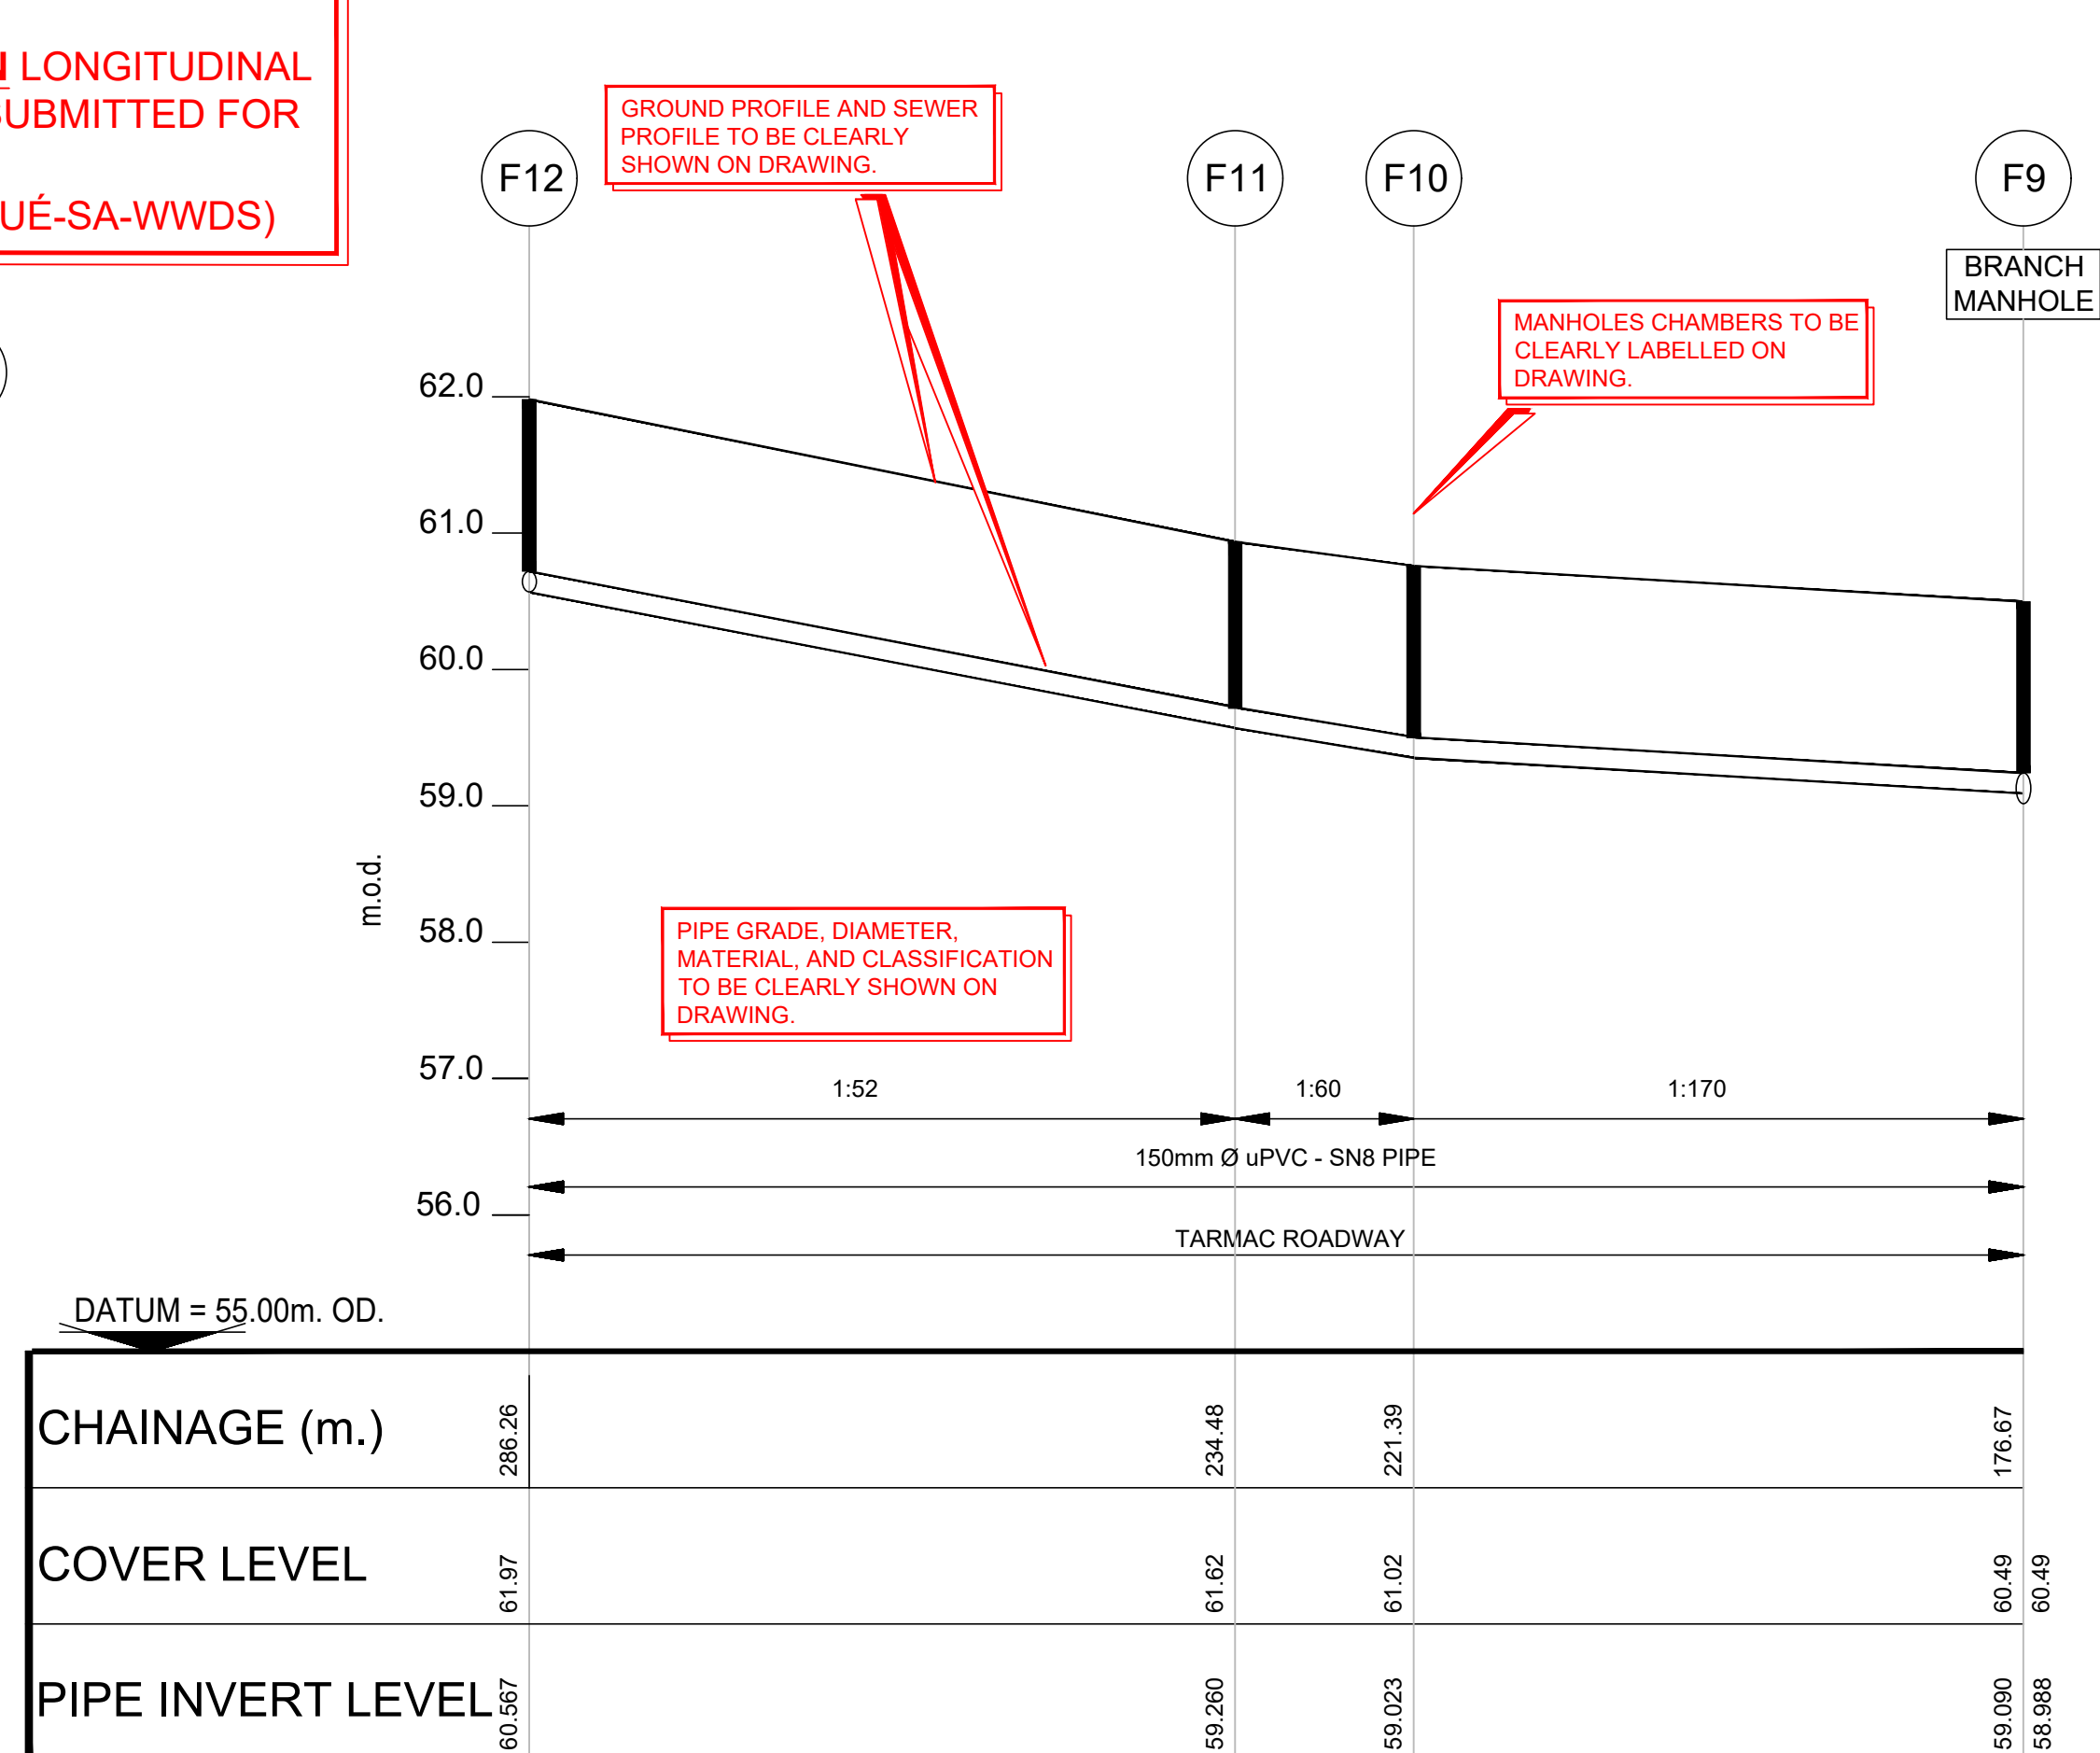

Horizontal Scale = 1:500, Vertical Scale = 1:50.

Horizontal Scale = 1:500, Vertical Scale = 1:50.

Horizontal Scale = 1:500, Vertical Scale = 1:50.

CDS-1900xxxxxx

DRAWING TO BE REVISED  
TO "AS-BUILT" STATUS

Local Authority

DEVELOPMENT TITLE TO BE CLEARLY STATED.

Consultant

NAME AND ADDRESS OF  
DEVELOPER AND/OR CONSULTANT  
TO BE CLEARLY SHOWN.

WASTEWATER  
LONGITUDINAL SECTIONS

DRAWING TITLE TO BE CLEARLY STATED.

Drawn XX	Scale AS SHOWN	Drawing Number 002-UÉ-SA-WWDS	Rev. A
Chkd. XX	Date XXX 20XX		
Apprd. XX	Status DESIGN		