


c:\users\hcoran\one\drive - usise - fireann\00-standard details\2025 - revision\2025 standard details\2025 - cad standards sample drawings\01 - design submission dgs\004-1e-sa-wvds.dwg 23/01/2025

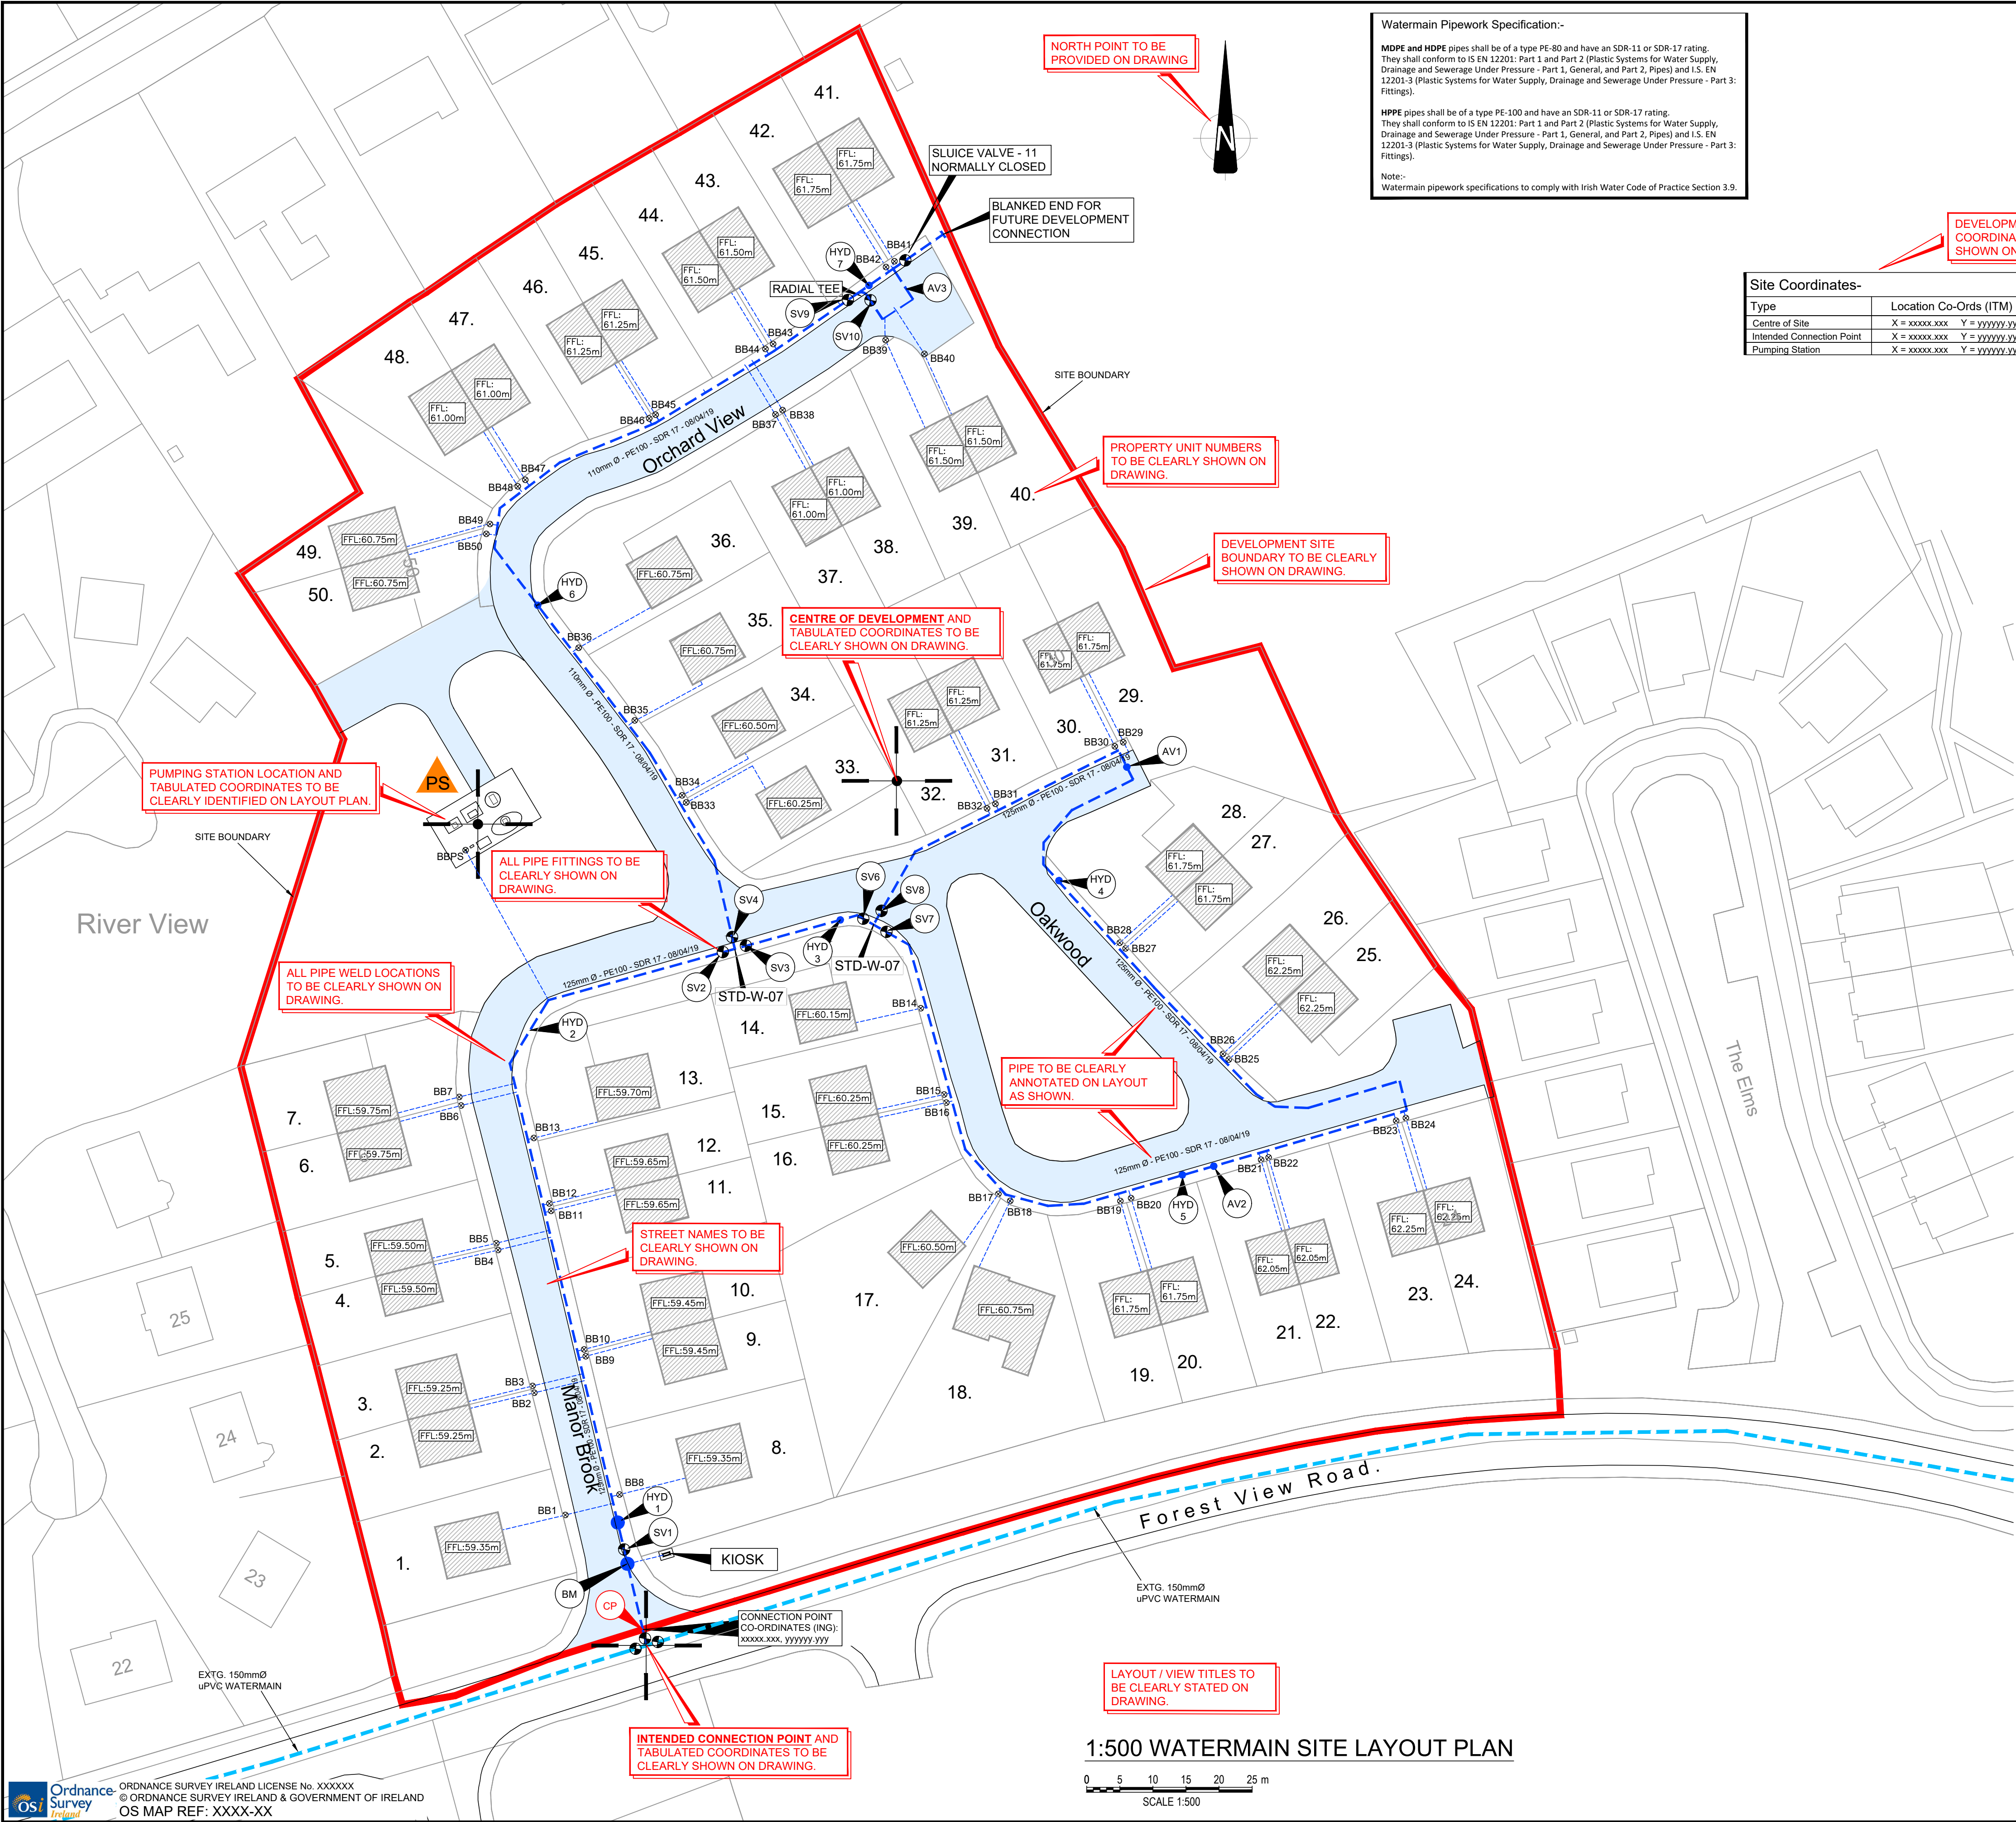

**SAMPLE
DRAWING**

PRE CONNECTION ENQUIRY NUMBER OR
CONNECTION APPLICATION NUMBERTO
BE CLEARLY STATED ON DRAWING.
(IF AVAILABLE)

CDS-1900xxxxxx

DRAWING TO BE REVISED
TO "AS-BUILT" STATUS

REV.	DATE	DESCRIPTION	BY	CHKD	APPR
A	XXX 20XX	DESIGN SUBMISSION	XX	-	-

Development

DEVELOPMENT TITLE TO BE
CLEARLY STATED.

Developer / Consultant

NAME AND ADDRESS OF
DEVELOPER AND/OR CONSULTANT
TO BE CLEARLY SHOWN.

Title

WATERMAIN SITE LAYOUT PLAN

DRAWING TITLE TO BE
CLEARLY STATED.

Drawn	XX	Scale	AS SHOWN	Drawing Number	Rev.
Chkd	XX	Date	XXX 20XX	004-UÉ-SA-WDS	A
Apprd.	XX	Status	DESIGN		