



c:\users\irishwater\onepointdrive - uisce eireann\00-standard details\2025 - revision\2025-standard details\2025-revision water
standard details\2025 - appendix - water sample drawings\01-as-built-sample\005-irish-water_01\internal new\drawing
09_12_2024

No part of this drawing may be reproduced or transmitted in any form or stored in any retrieval system of any nature without the written
permission of Irish Water as copyright holder except as agreed for use on the project for which the document was originally issued.

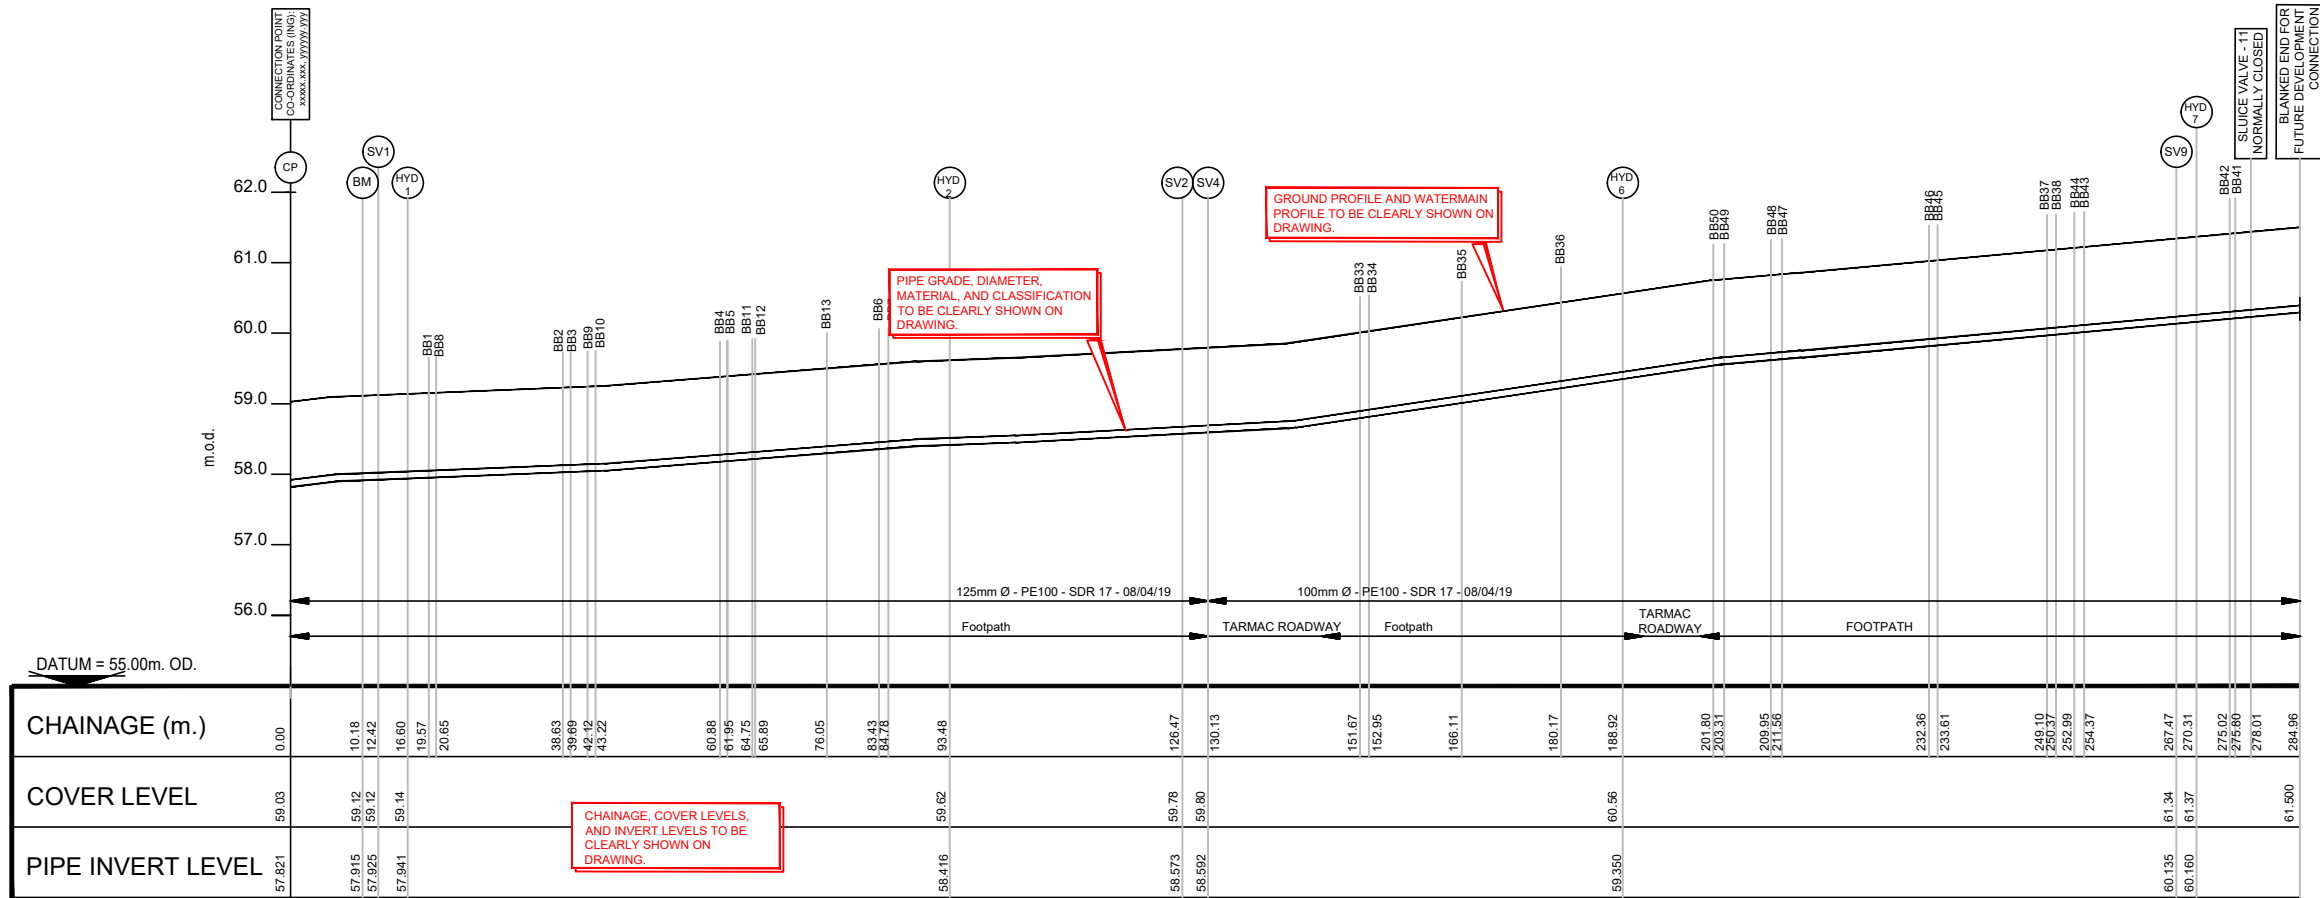

WATERMAIN LONGITUDINAL SECTION

Horizontal Scale = 1:500, Vertical Scale = 1:50.

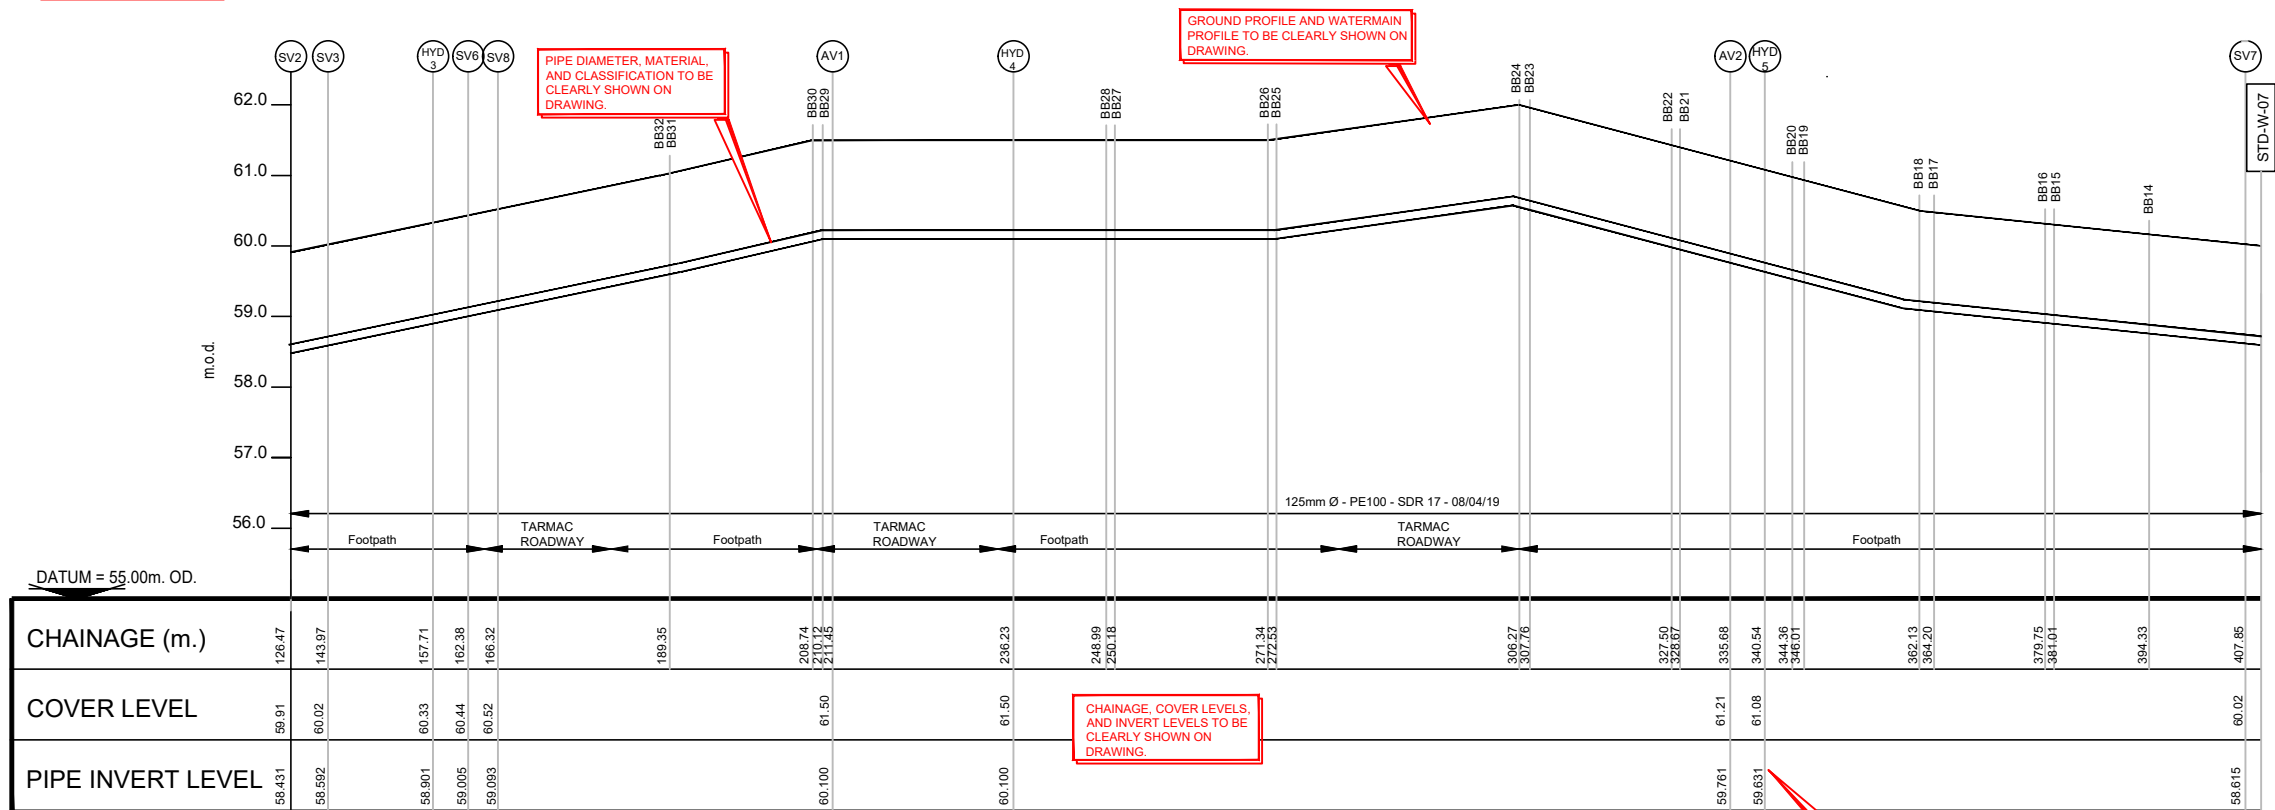

WATERMAIN LONGITUDINAL SECTION

Horizontal Scale = 1:500, Vertical Scale = 1:50.

LAYOUT / VIEW TITLES TO
BE CLEARLY STATED ON
DRAWING.

CHAINAGE, COVER LEVELS,
AND INVERT LEVELS TO BE
CLEARLY SHOWN ON
DRAWING.

INVERTS SHOWN ON ALL
MAJOR ELEMENTS AS PER
DRAWING.

**SAMPLE
DRAWING**

CDS TRACKER NUMBER TO
BE CLEARLY STATED ON
DRAWING.

CDS-1900xxxxxx

DRAWING TO BE REVISED
TO "AS-BUILT" STATUS

REV.	DATE	DESCRIPTION	BY	CHKD	APPR
AB1	MAR 2025	AS-BUILT RECORD DRAWING	RH	-	-



Local Authority

DEVELOPMENT TITLE TO BE
CLEARLY STATED.

Consultant

NAME AND ADDRESS OF
DEVELOPER AND/OR CONSULTANT
TO BE CLEARLY SHOWN.

WATERMAIN
LONGITUDINAL SECTIONS

DRAWING TITLE TO BE
CLEARLY STATED.

Drawn	Scale	AS SHOWN	Drawing Number	Rev.
RH			005-IS-SA-WA	AB1
Chkd	Date	AS-BUILT		
RH	MAR 2025			
Apprd	Status			
M McG	AS-BUILT			